


7 FEET WIDE WALKWAY

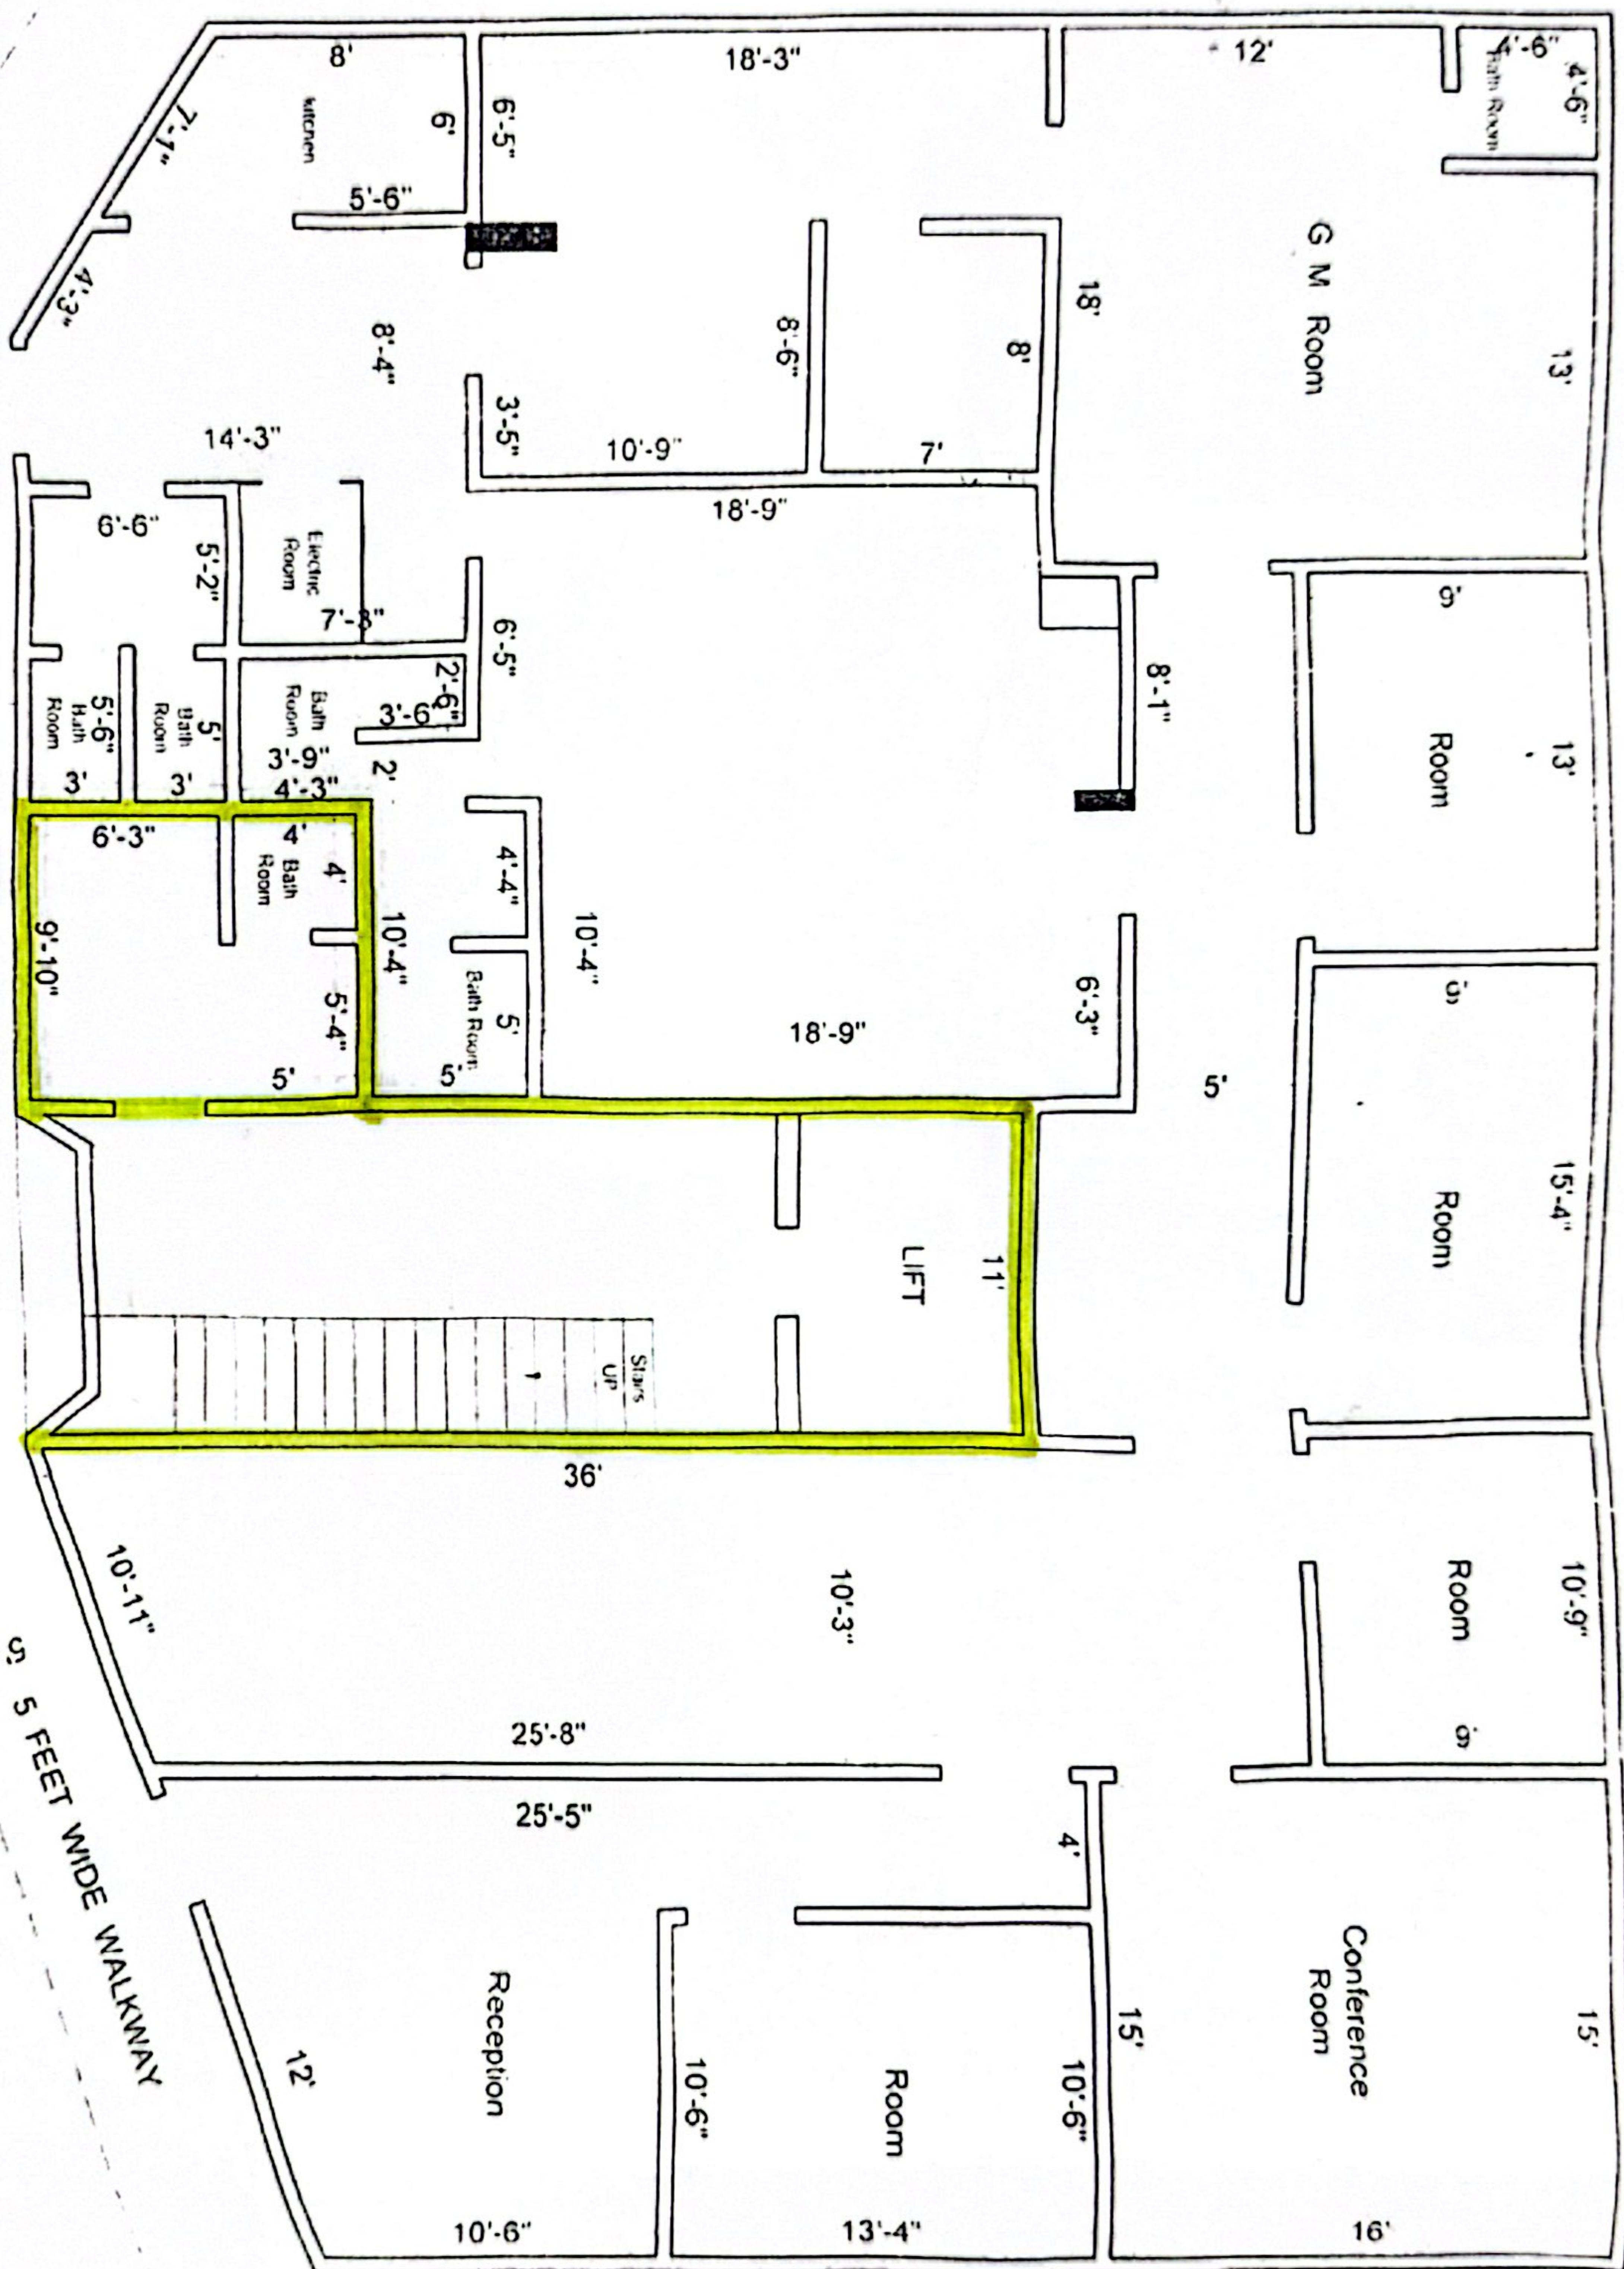

5 5 FEET WIDE WALKWAY

EXISTING 20 FEET WIDE ROAD

5 5 FEET WIDE WALKWAY

EXISTING ROAD

ASBUILT PLAN
YASIR SIDDIQUI